EQUIP. TYPE R390A/URR EXP. NO.

COL. 540 7574 003

NOTICE: WHEN GOVERNMENT DRAWINGS, SPECIFICATIONS, OR OTHER DATA ARE USED FOR ANY PURPOSE OTHER THAN IN CONNECTION WITH A DEFINITELY RELATED GOVERNMENT PROCUREMENT OPERATION, THE UNITED STATES GOVERNMENT THEREBY INCURS NO RESPONSIBILITY NOR ANY OBLIGATION WHATSOEVER; AND THE FACT THAT THE GOVERNMENT MAY HAVE FORMULATED, FURNISHED, OR IN ANY WAY SUPPLIED THE SAID DRAWINGS, SPECIFICATIONS, OR OTHER DATA IS NOT TO BE REGARDED BY IMPLICATION OR OTHERWISE AS IN ANY MANNER LICENSING THE HOLDER OR ANY OTHER PERSON OR CORPORATION, OR CONVEYING ANY RIGHTS OR PERMISSION TO MANUFACTURE, USE, OR SELL ANY PATENTED INVENTION THAT MAY IN ANY WAY BE RELATED THERETO.

THIS DOCUMENT HAS BEEN FURNISHED BY THE GOVERNMENT AND MAY BE REPRODUCED AND USED IN CONNECTION WITH ANY GOVERNMENT PROCUREMENT OR MAINTENANCE OPERATION.

*FOR INFORMATION ONLY. CONTRACTOR MAY AT HIS OPTION DEVIATE FROM THESE PROCESS DETAILS.

~~X SWE APPROVAL~~

~~SYM PR 100 FEB 9~~

REVISIONS			
SYM	DESCRIPTION	DATE	APPROVAL
A_5	A_1 - NOTE 2 WAS SILKSCREENING METHOD A_2 - "SEE NOTE 2" WAS SILK SCREEN DWG CALLOUT A_3 - 5052 WAS 52S A_4 - ADDED THK DIM TO VIEW A_5 - DIMENSIONALLY LOCATED ALL MARKINGS	4 NOV. 59	4-2428-PC-59-A1-61 CHK'D PME

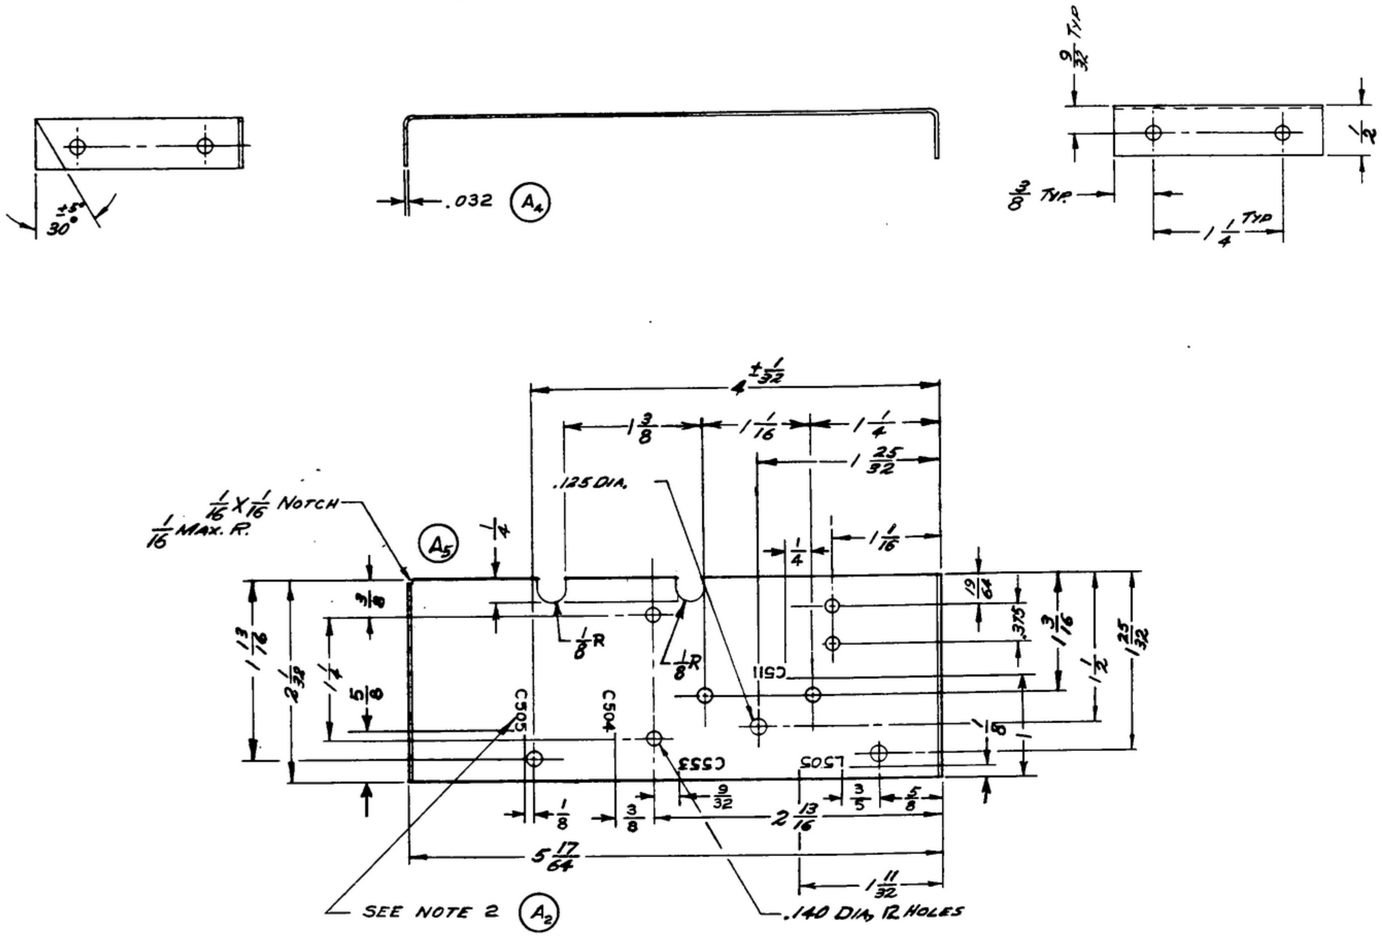

A3

ALUMINUM ALLOY, 5052 TEMPER H34, PER SPEC QQ-A-318,

FINISH: E513 PER SPEC MIL-F-14072

~~* COLLINS 538-0036-00~~

NOTES:

1. 1/16 MAX INSIDE BEND RADIUS.
2. A1 ALL CHARACTERS TO BE 3/32 HIGH GOTHIC TYPE PER SPEC MIL-M-13231 GROUP II COLOR TO BE BLACK, COLOR CHIP NO. 27038 PER FED STD 595. MARKINGS TO BE CENTRALLY LOCATED ± 1/32 UNLESS OTHERWISE SHOWN. COVER DESIGNATIONS WITH 1 COAT OF VARNISH PER MIL-V-173 TYPE II.

~~558-0022-002 1 REF SM-B-248800 SILK SCREEN I.F. SHIELD~~

~~COLLINS PART NO.~~	ITEM	REQD	PART NO.	DESCRIPTION	MATL	SPECIFICATION

LIST OF MATERIAL ~~COLLINS PART NO. 558-0360-003~~

~~COLLINS NO.~~	~~QTY~~	NEXT ASSY	USED ON
~~558-0343-002~~	1	SM-B-248993	SC-DL-248775

APPLICATION

DRAWN EC5 | CHECKED | APPROVED

UNLESS OTHERWISE SPECIFIED:
DECIMAL DIMENSIONS INCLUDING HOLE SIZES MAY VARY ±.005
FRACTIONAL DIMENSIONS INCLUDING HOLE SIZES MAY VARY ±1/64
MACHINED ANGLES MAY VARY ±.1°
SHEARED ANGLES MAY VARY ±.25°
BROKEN ANGLES MAY VARY ±1°
ECCENTRICITY BETWEEN ANY DIAMETERS ON THE SAME CENTERLINE SHALL NOT EXCEED .010 TOTAL INDICATOR READING.
ALL DIMENSIONS ARE FINISH DIMENSIONS INCLUDING APPLIED FINISH AND ARE GIVEN IN INCHES.

~~COLLINS RADIO CO. CEDAR RAPIDS, IOWA~~
14214-PH-51-93

SIGNAL CORPS

REVIEWED PME

APPROVED HLY PME

DATE 30 Dec 55 | SCALE 1/1

SHIELD-I.F.

DEPARTMENT OF THE ARMY
SIGNAL CORPS ENGINEERING LABORATORIES
FORT MONMOUTH NEW JERSEY

SM-C-249011

WHEN REFERRING TO THIS DRAWING STATE DRAWING NO., APPLICABLE ISSUE SYMBOL, IF ANY, AND DATE